


PRINTED Feb 08, 2017 - 9:07am FILENAME - J:\6005.1-(RECORD DRAWINGS)\Contract 3663 - Bullard SPS - (Record Drawings) - February 2017\SH7 27_BULL_LONG_SEC (RECORD DRAWING).dwg

FOR REFERENCE
ONLY

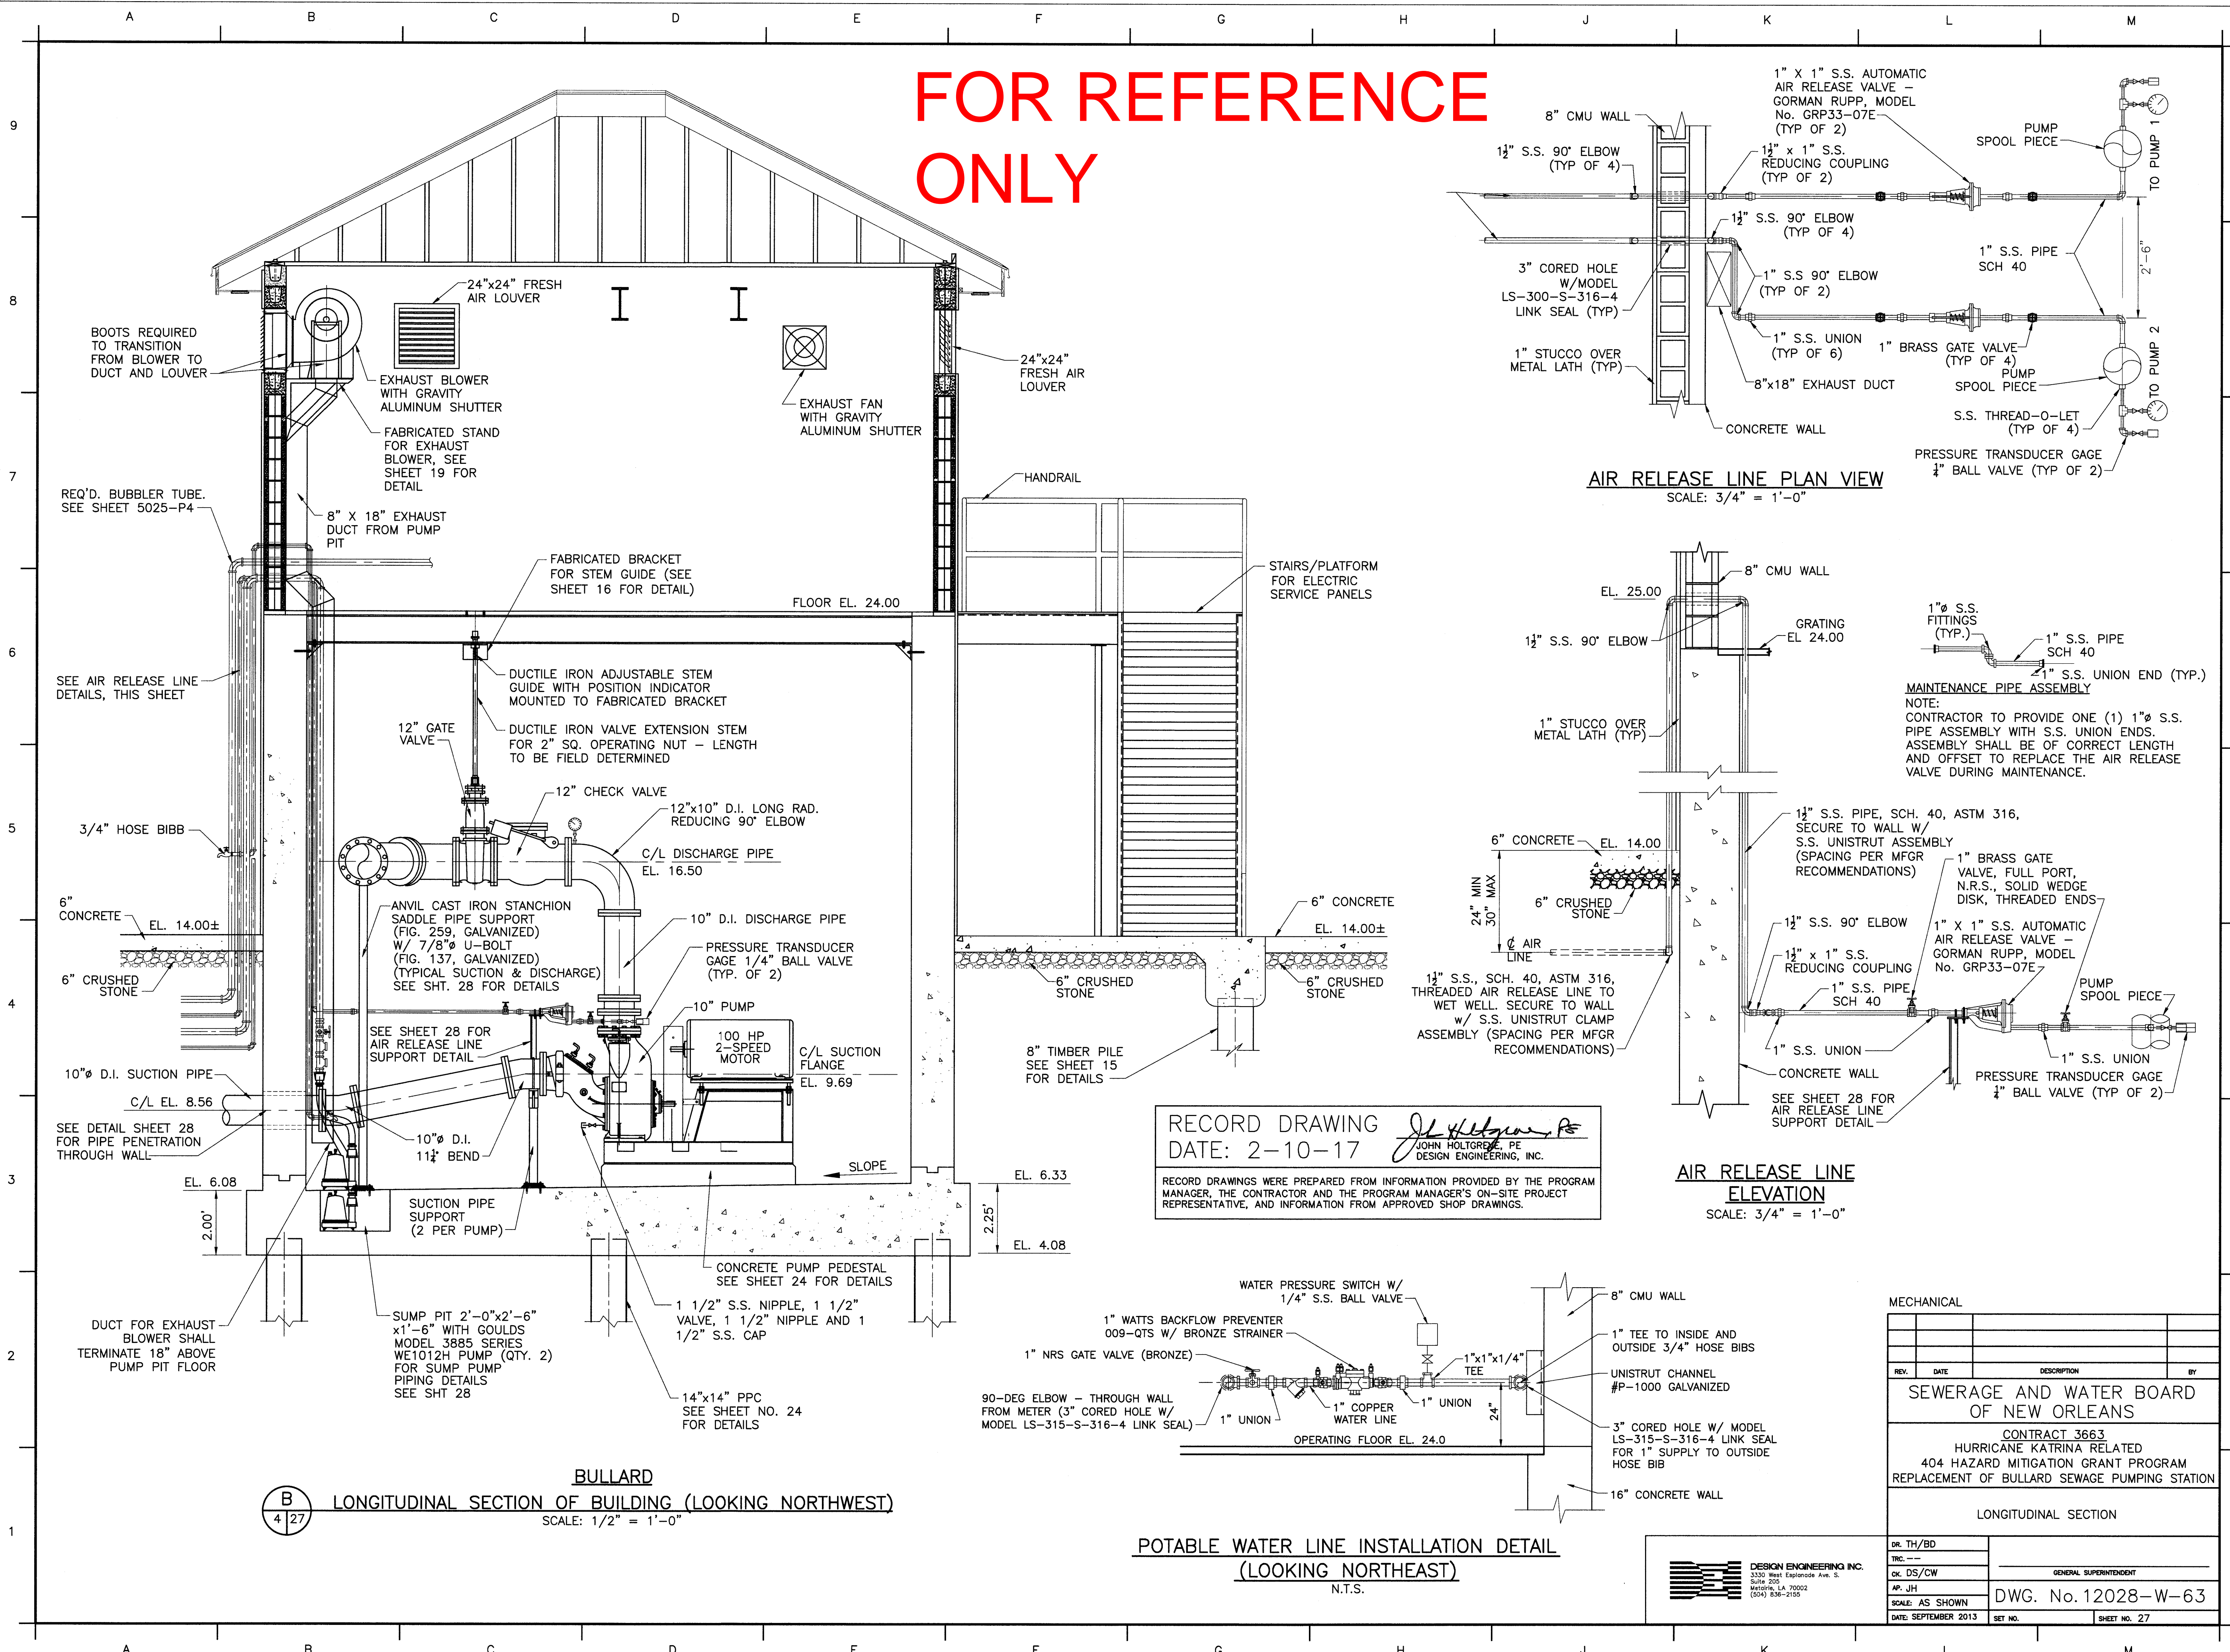

AIR RELEASE LINE PLAN VIEW
SCALE: 3/4" = 1'-0"

AIR RELEASE LINE
ELEVATION
SCALE: 3/4" = 1'-0"

RECORD DRAWING
DATE: 2-10-17
JOHN HOLTORE, P.E.
DESIGN ENGINEERING, INC.
RECORD DRAWINGS WERE PREPARED FROM INFORMATION PROVIDED BY THE PROGRAM
MANAGER, THE CONTRACTOR AND THE PROGRAM MANAGER'S ON-SITE PROJECT
REPRESENTATIVE, AND INFORMATION FROM APPROVED SHOP DRAWINGS.

POTABLE WATER LINE INSTALLATION DETAIL
(LOOKING NORTHEAST)
N.T.S.

MECHANICAL			
REV.	DATE	DESCRIPTION	BY
SEWERAGE AND WATER BOARD OF NEW ORLEANS			
CONTRACT 3663 HURRICANE KATRINA RELATED 404 HAZARD MITIGATION GRANT PROGRAM REPLACEMENT OF BULLARD SEWAGE PUMPING STATION			
LONGITUDINAL SECTION			
DR. TH/BD			
TRC			
CH. DS/CW			
AP. JH			
SCALE: AS SHOWN			
DATE: SEPTEMBER 2013	SET NO.		SHEET NO. 27