


RECORD DRAWING
DATE: 2-10-17

J. H. Heston
JOHN HESTON, P.E.
DESIGN ENGINEERING, INC.


RECORD DRAWINGS WERE PREPARED FROM INFORMATION PROVIDED BY THE PROGRAM MANAGER, THE CONTRACTOR AND THE PROGRAM MANAGER'S ON-SITE PROJECT REPRESENTATIVE, AND INFORMATION FROM APPROVED SHOP DRAWINGS.

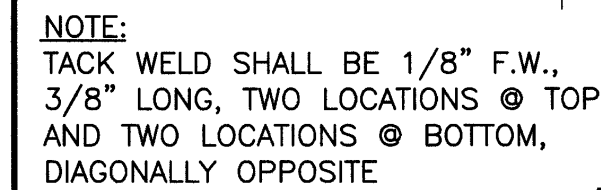

DETAIL 1




SCALE: 1"=1'-0"

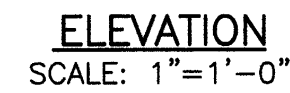



SCALE: 3"=1'-0"




C SECTION
2828 SCALE: 3"=1'-0"

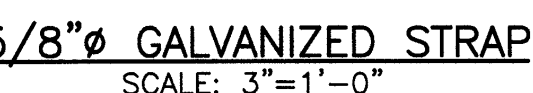

1/4"Ø GALVANIZED STRAP
(FOR AIR RELEASE VALVE)

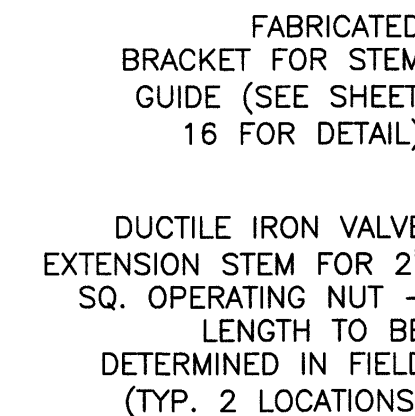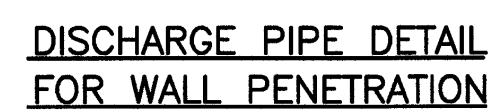

SCALE: $1/2" = 1'-0"$

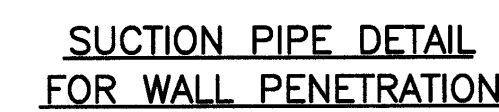

MECHANICAL			
REV.	DATE	DESCRIPTION	BY
SEWERAGE AND WATER BOARD OF NEW ORLEANS			
CONTRACT 3663 HURRICANE KATRINA RELATED 404 HAZARD MITIGATION GRANT PROGRAM REPLACEMENT OF BULLARD SEWAGE PUMPING STATION			
PIPING CROSS SECTION THROUGH STATION AND MISCELLANEOUS DETAILS			
DR. TH/BD			
TIC: --			
CK-D/CW	GENERAL SUPERINTENDENT		
AP. JH			
SCALE: AS SHOWN	DWG. No. 12028-W-63		
DATE: SEPTEMBER 2013	SET NO.	SHEET NO. 28	



DESIGN ENGINEERING INC.
3330 West Esplanade Ave. S.
Suite 205
Metairie, LA 70002
(504) 836-2155